
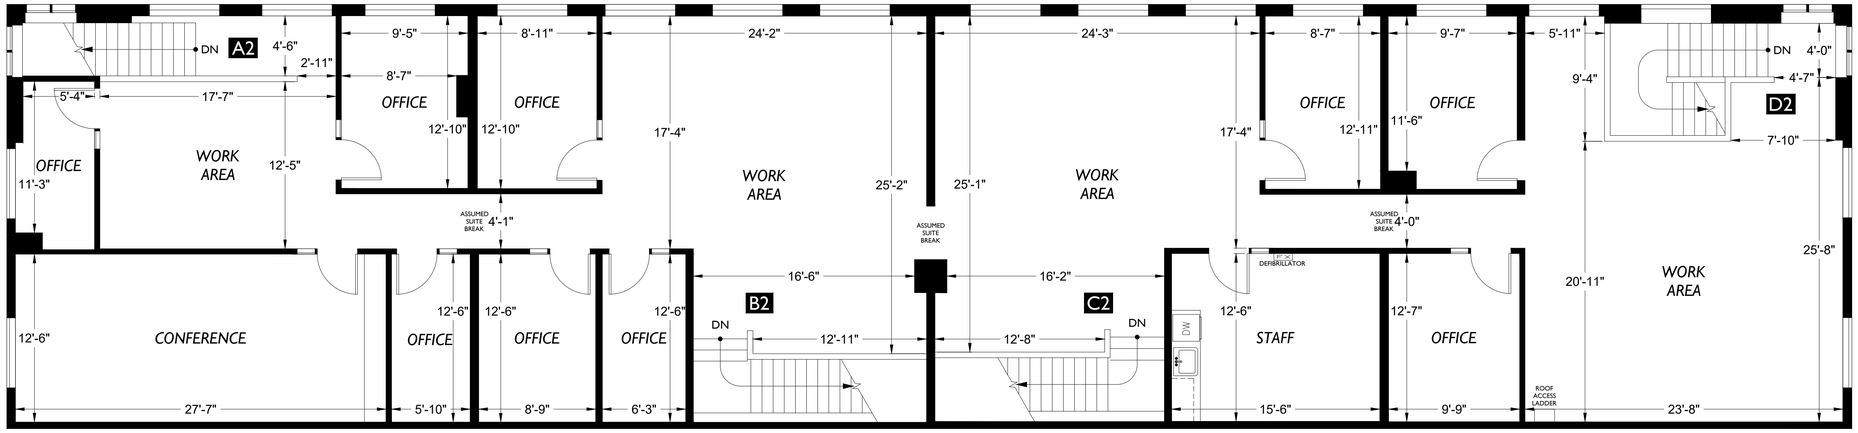

FLOOR 2

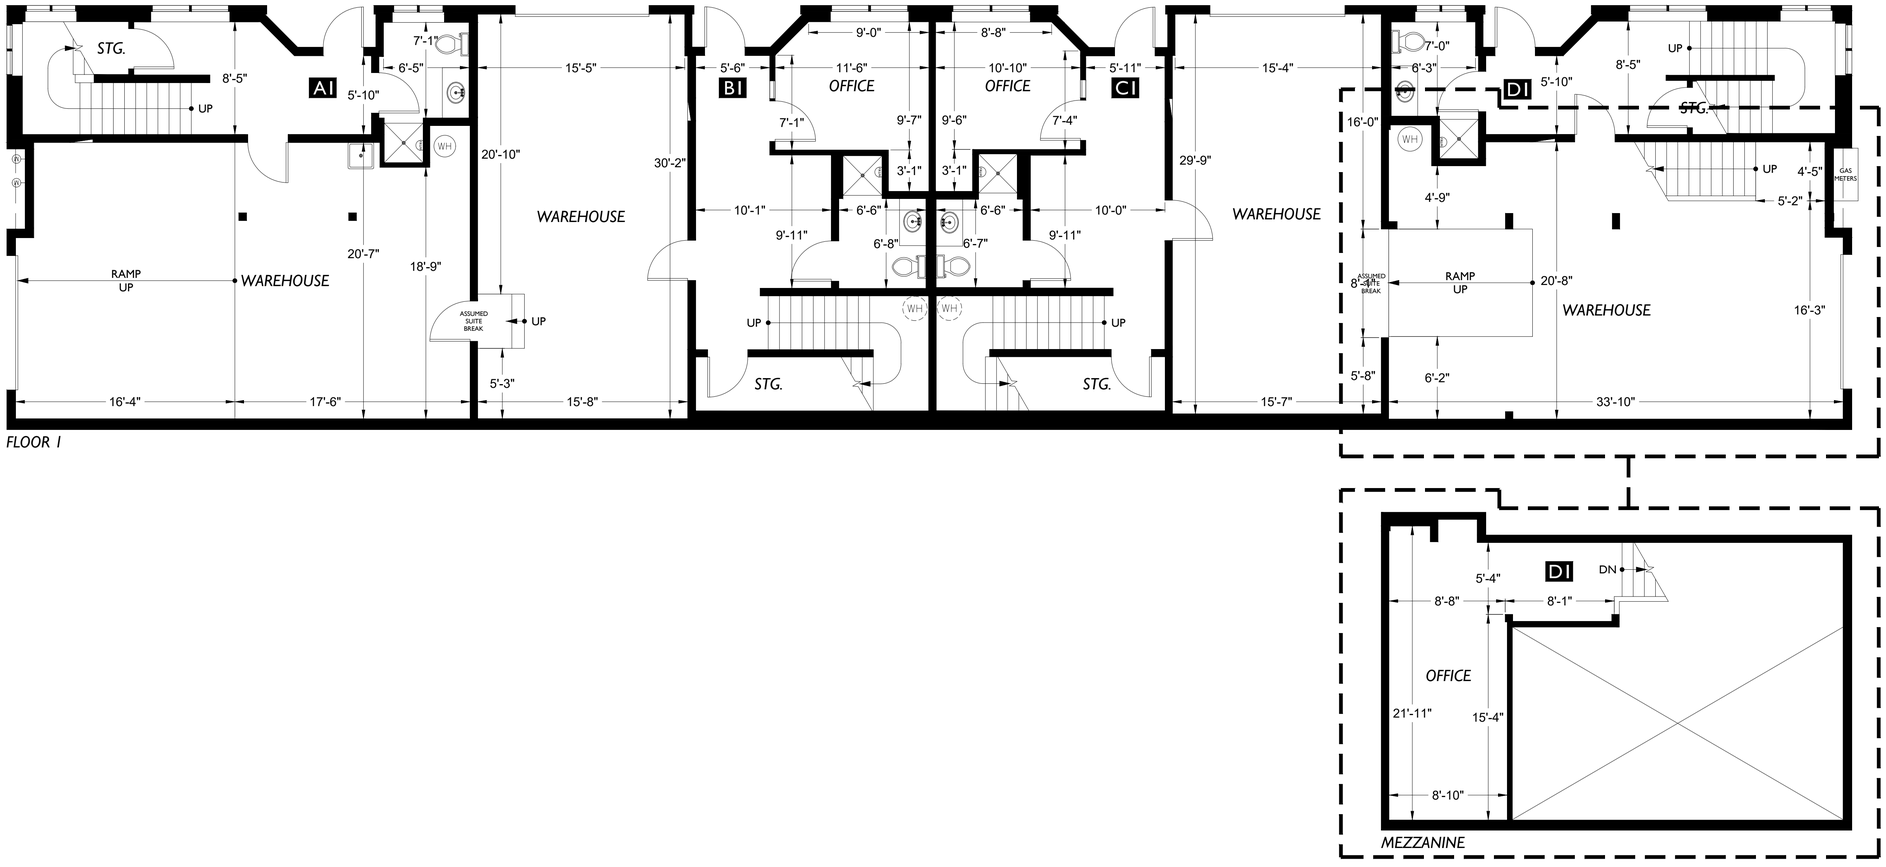

FLOOR 1

MEZZANINE


0 5 10 15 20 25 30

Scale: 3/16" = 1'-0"



2-D AS-BUILT FLOOR PLANS

2DFLOORPLANS.COM

371 NW Gilman Blvd.
Suite 140
Issaquah, WA 98027
425-677-7511

This drawing is an instrument of service and is the sole property of the client listed. Any alteration of this drawing without removal of references to 2-D As-Built Floor Plans, Inc. is prohibited.

Drawing scale and dimensions are provided for reference only. Refer to CAD files for exact measurements.

©2010 2-D As-Built Floor Plans, Inc. All Rights Reserved.

Project: C23-106

Date Project	Action
9/5/2023	Initial Building Measure
C23-106	

Site:
Industrial Building
4259 23rd Avenue West
Seattle, WA 98199

Floor Plan

Floor